
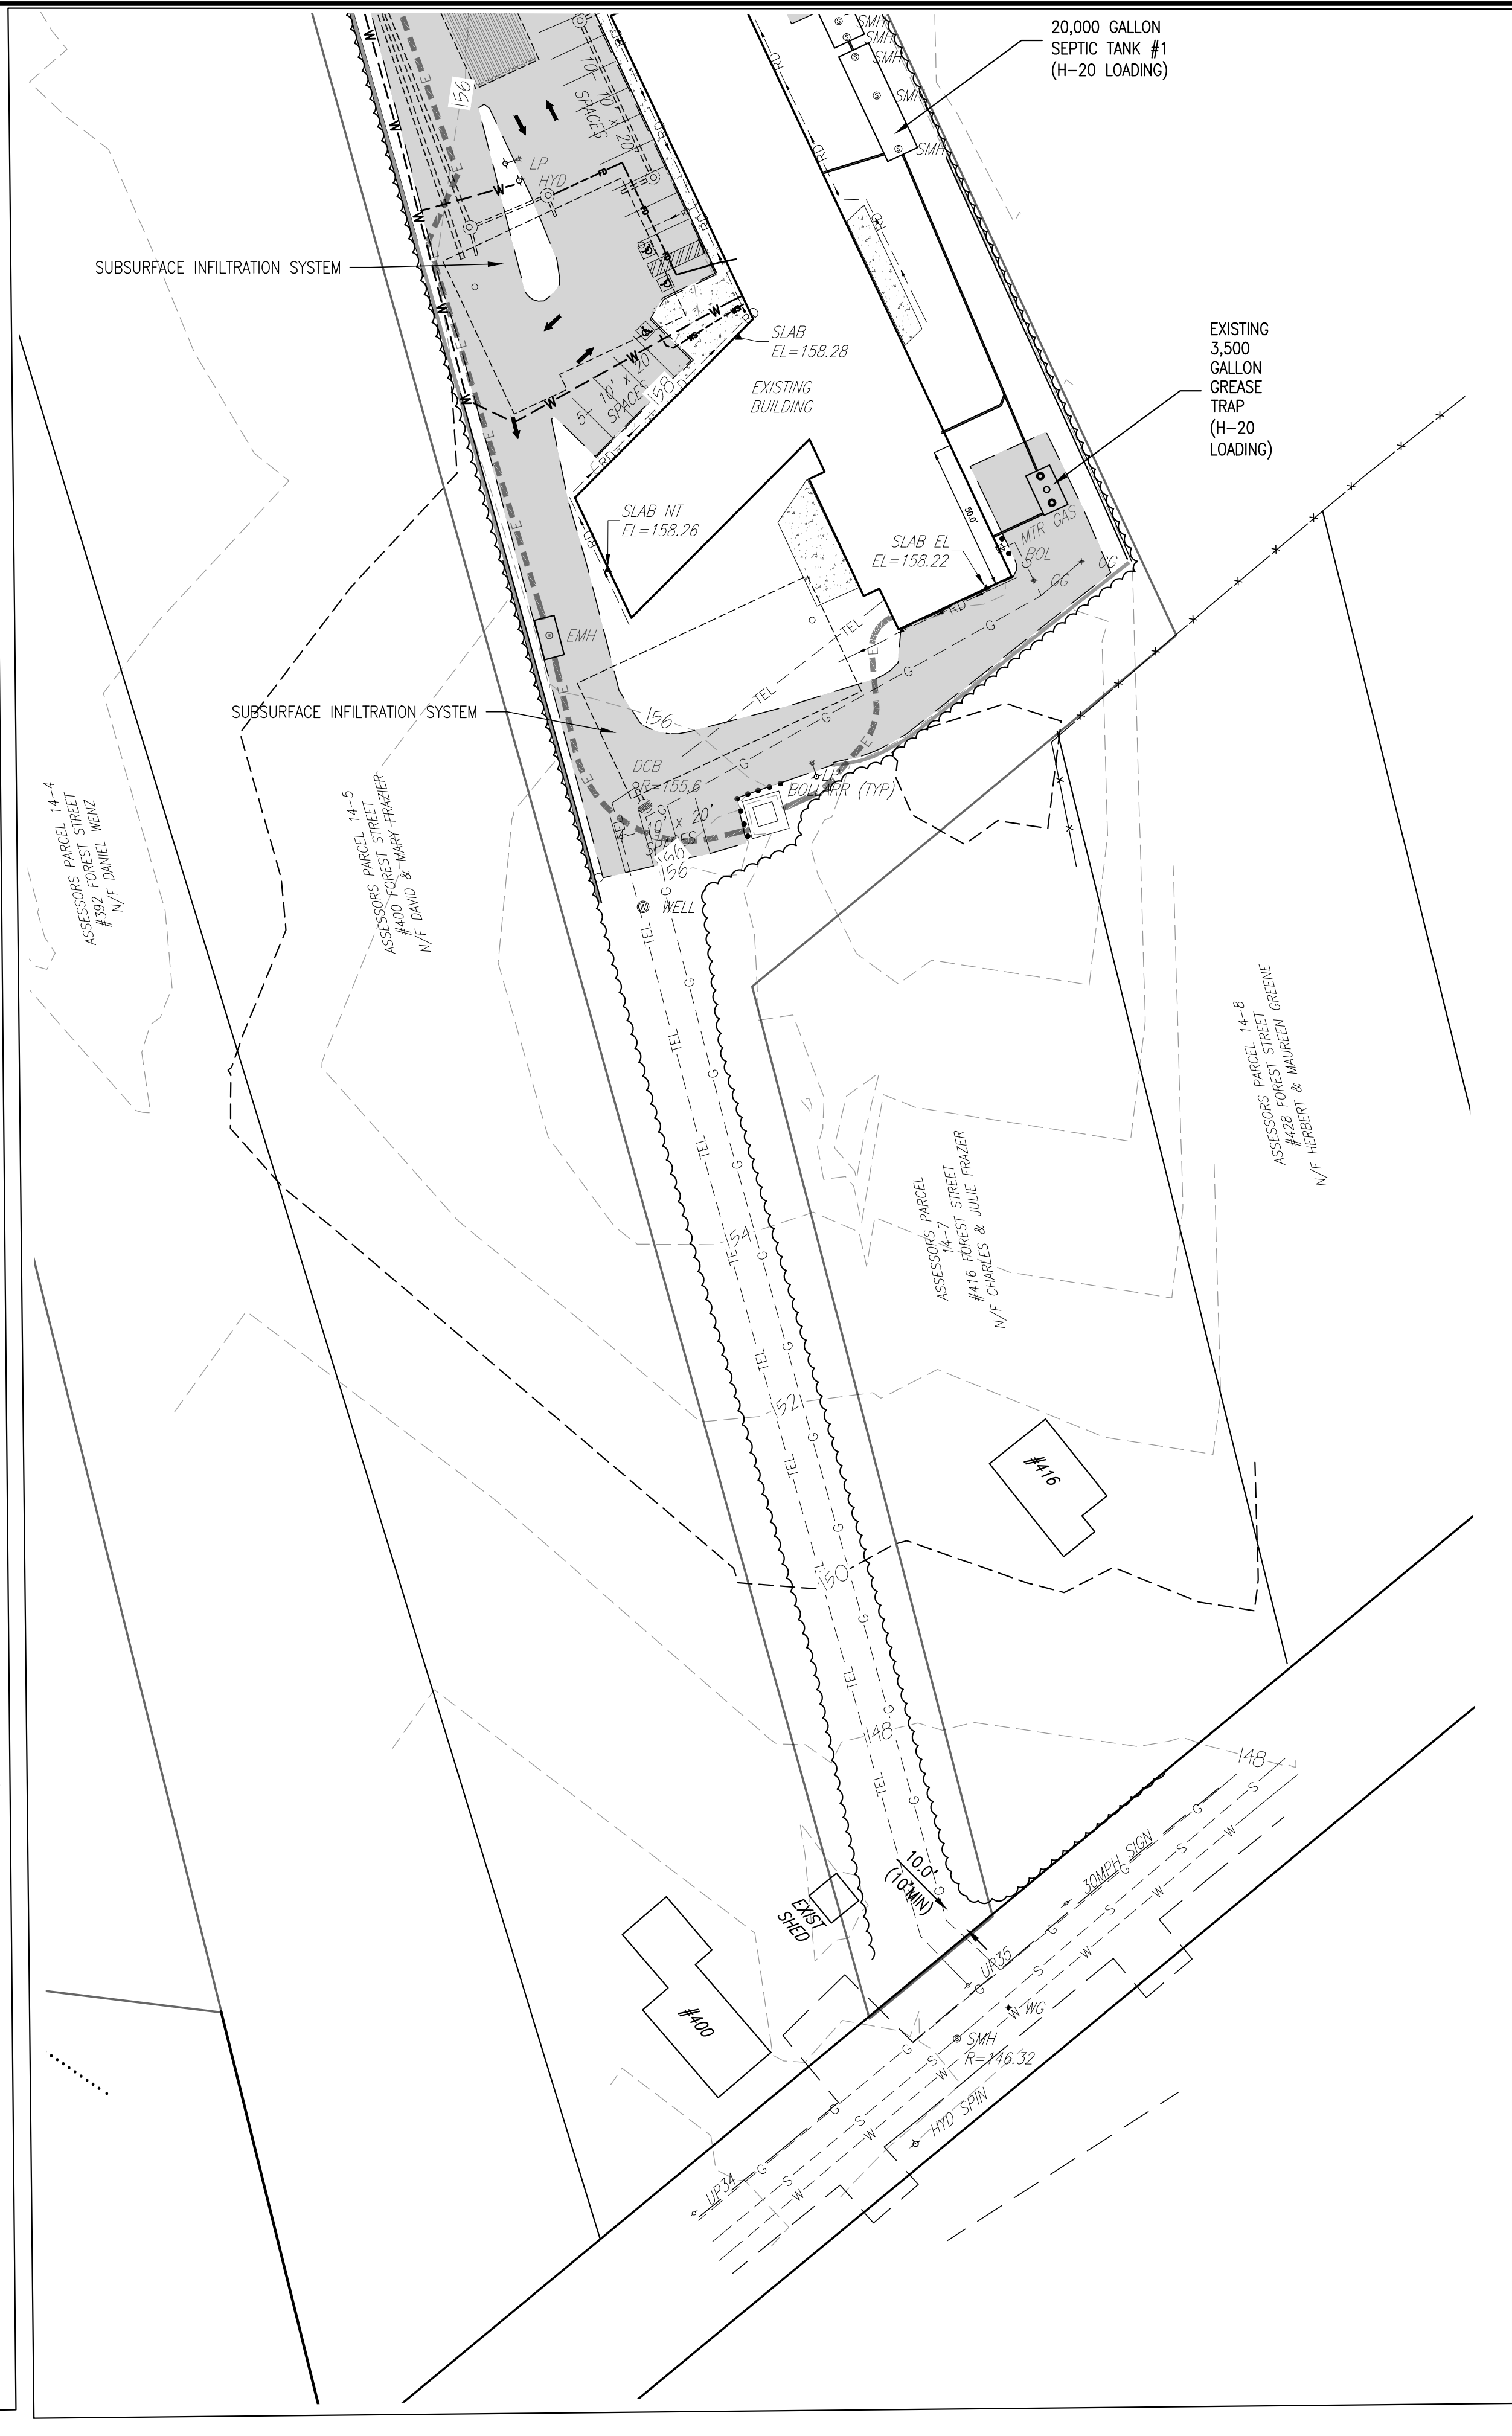


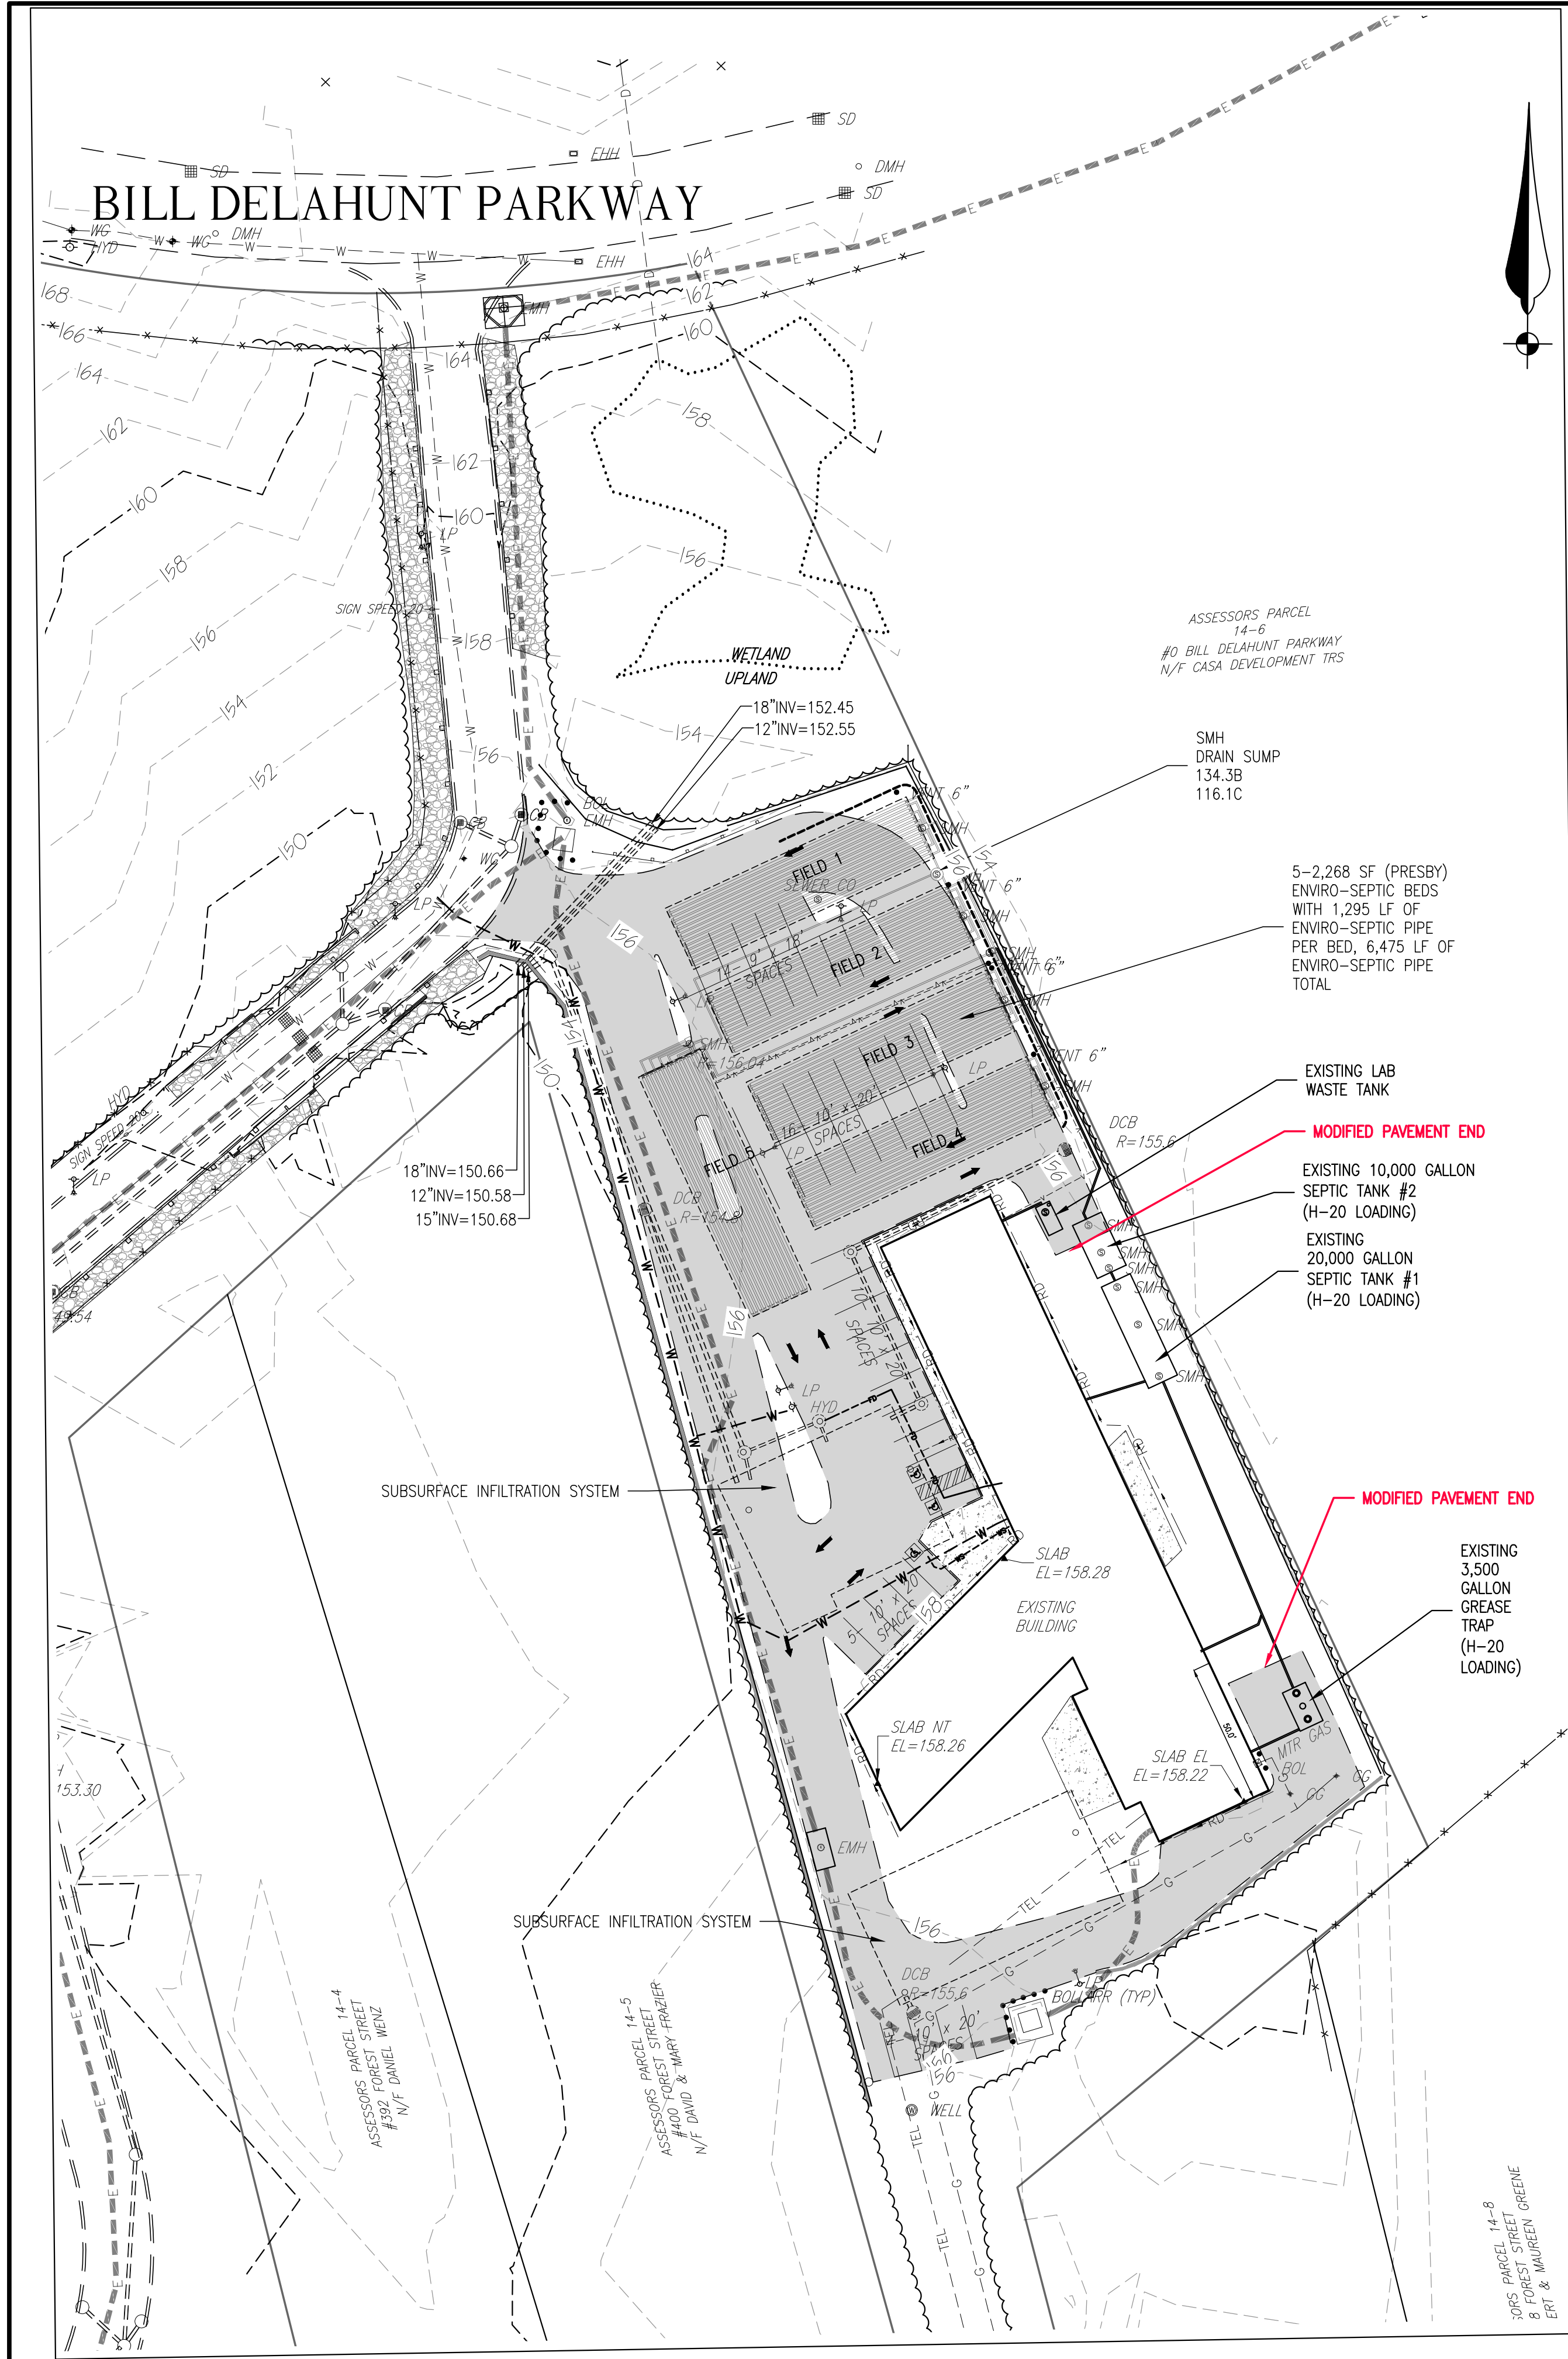

RECORD OWNER:
ASSESSOR MAP 14 LOT 92
0 BILL DELAHUNT PARKWAY
FOREST DELAHUNT DEVELOPMENT LLC
DEED BOOK 54183 PAGE 246
PLAN BOOK 64 PAGE 822

ASSESSOR MAP 19 LOT 47
0 FOREST STREET
FOREST DELAHUNT DEVELOPMENT LLC
DEED BOOK 54183 PAGE 246
PLAN BOOK 64 PAGE 822
CERTIFICATE 131245
LC PLAN 35481A

ASSESSOR MAP 19 LOT 108
0 FOREST STREET
FOREST DELAHUNT DEVELOPMENT LLC
BOOK 53981 PAGE 301
CERTIFICATE 131244
LC PLAN 35481B


ASSESSOR MAP 13 LOT 3
338 FOREST STREET
FOREST DELAHUNT DEVELOPMENT LLC
DEED BOOK 53980 PAGE 301
PLAN BOOK 25 PAGE 423

ASSESSOR MAP 13 LOT 1
0 FOREST STREET
FOREST DELAHUNT DEVELOPMENT LLC
DEED BOOK 54183 PAGE 246
PLAN BOOK 64 PAGE 822

FOR REGISTRY USE ONLY

DATE APPROVED: _____

DATE SIGNED: _____

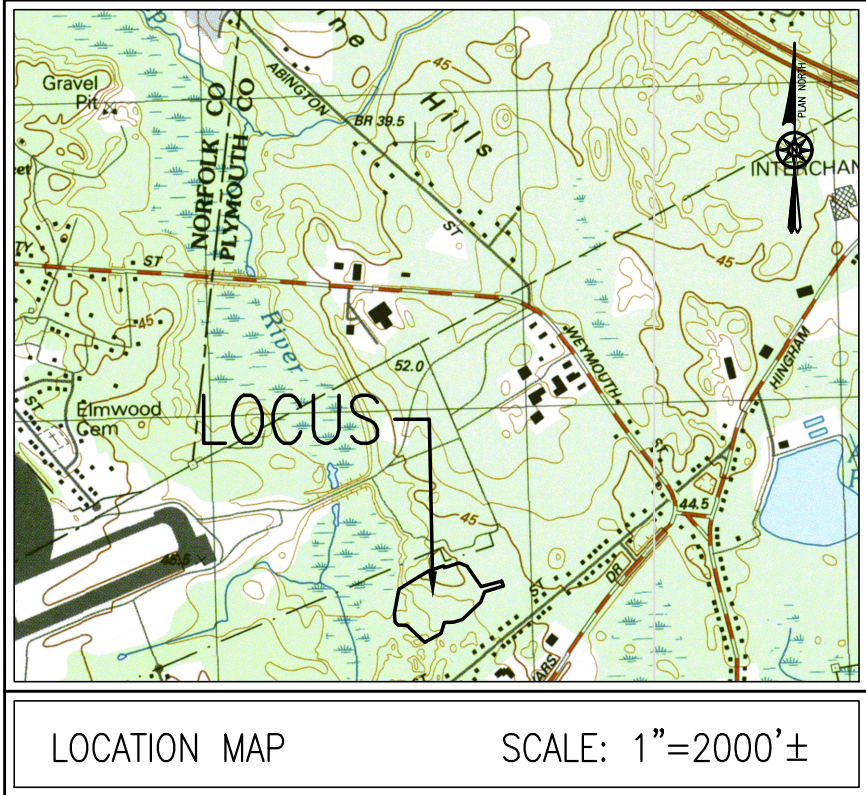

MODIFICATION REQUEST 2023-07-21

SITE PLAN

LOVELL ACADEMY
#80 BILL DELAHUNT PARKWAY
ASSESSORS LOT 14-092
ROCKLAND, MASSACHUSETTS

PREPARED FOR:
FOREST DELAHUNT DEVELOPMENT LLC
LAUREN MONAHAN MANAGING PARTNER
129 JACOBS LANE
NORWELL MA 02061

JUNE 15, 2023
SCALE: 1"=_____
JOB No. 17-276

GRADY CONSULTING, L.L.C.
Civil Engineers, Land Surveyors &
Landscape Architects
71 Evergreen Street, Suite 1, Kingston, MA 02364
Phone (781) 585-2300 Fax (781) 585-2378

Planning Received 7.21.23

Scale 1" = 40'