Planning Received 10/27/25



CARLOS FERREIRA
NO 41423
NO A1423

11 TYPE A - GROUND LEVEL 1/4" = 1'-0" SCHEDULE OF AREAS

GARAGE GROUND FIRST FLOOR SECOND FLOOR
UNIT 12 293 SQ.FT. 483 SQ.FT. 792 SQ.FT. 512 SQ.FT.
UNIT 14 293 SQ.FT. 483 SQ.FT. 792 SQ.FT 512 SQ.FT.

DIMENSIONS LISTED ABOVE ARE GROSS SQUARE FOOTAGE MEASURE TO THE EXTERIOR WALLS

I CARLOS FERREIRA, MASSACHUSETTS PROFESSIONAL ENGINEER, CERTIFY THAT THIS PLAN HAS BEEN PREPARED IN CONFORMITY WITH THE RULES AND REGULATIONS OF THE REGISTRAR OF DEEDS OF THE COMMONWEALTH OF MASSACHUSETTS.

I CERTIFY THAT THIS PLAN FULLY AND ACCURATELY DEPICTS THE LAYOUT, LOCATION, UNIT NUMBER AND DIMENSIONS OF BUILDING A UNITS 12 and 14 EXCLUSIVE USE AREAS COMMON AREAS AND ARE THE DIMENSIONS OF THE UNITS AS BUILT OF THE GASPAR AT DYER 10 CONDOMINIUM LOCATED AT DYER STREET, ROCKLAND, MASSACHUSETTS.

OCTOBER 1, 2025

CARLOS FERREIRA PROFESSIONAL ENGINEER 41.423 MA

GASPAR AT DYER 10
Condominium
ADDRESS: DYER STREET - ROCKLAND, MA

Building 12-14 Unit Plan

Owner of Record

Gaspar at DYER 10 LLC


245 Willis Avenue

Medford, MA 02155

SCALE: 1/4" = 1'-0" OCTOBER 1, 2025

MF ENGINEERING & DESIGN

1188 CHESTNUT STREET - NEWTON , MA 02464 PHONE: (508) 331-7261

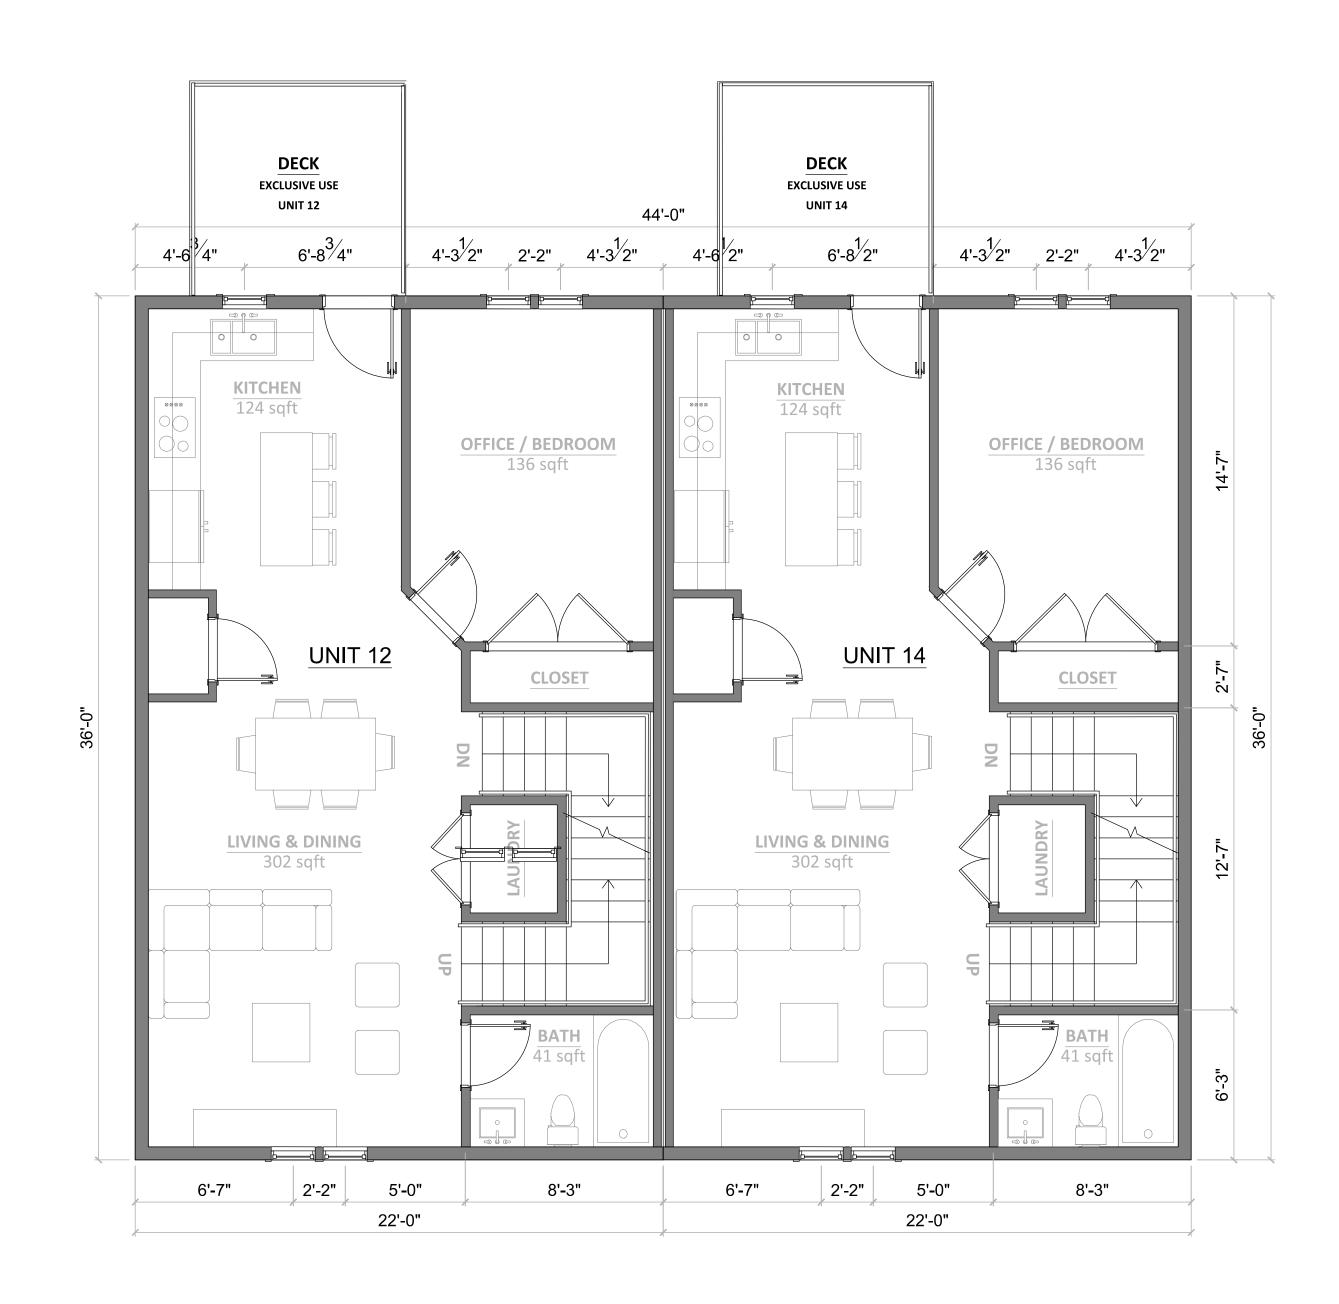

12 TYPE A - 1ST LEVEL 1/4" = 1'-0" I CARLOS FERREIRA, MASSACHUSETTS PROFESSIONAL ENGINEER, CERTIFY THAT THIS PLAN HAS BEEN PREPARED IN CONFORMITY WITH THE RULES AND REGULATIONS OF THE REGISTRAR OF DEEDS OF THE COMMONWEALTH OF MASSACHUSETTS.

I CERTIFY THAT THIS PLAN FULLY AND ACCURATELY DEPICTS THE LAYOUT, LOCATION, UNIT NUMBER AND DIMENSIONS OF BUILDING A UNITS 12 AND 14 EXCLUSIVE USE AREAS COMMON AREAS AND ARE THE DIMENSIONS OF THE UNITS AS BUILT OF THE GASPAR AT DYER 10 CONDOMINIUM LOCATED AT DYER STREET, ROCKLAND, MASSACHUSETTS.

CARLOS FERREIRA
NO 41423
NO 41423

OCTOBER 1, 2025

CARLOS FERREIRA PROFESSIONAL ENGINEER 41.423 MA

GASPAR AT DYER 10
Condominium
ADDRESS: DYER STREET - ROCKLAND, MA

Building 12-14 Unit Plan

Owner of Record

Gaspar at DYER 10 LLC


245 Willis Avenue

Medford, MA 02155

SCALE: 1/4" = 1'-0" OCTOBER 1, 2025

MF ENGINEERING & DESIGN

1188 CHESTNUT STREET - NEWTON , MA 02464 PHONE: (508) 331-7261

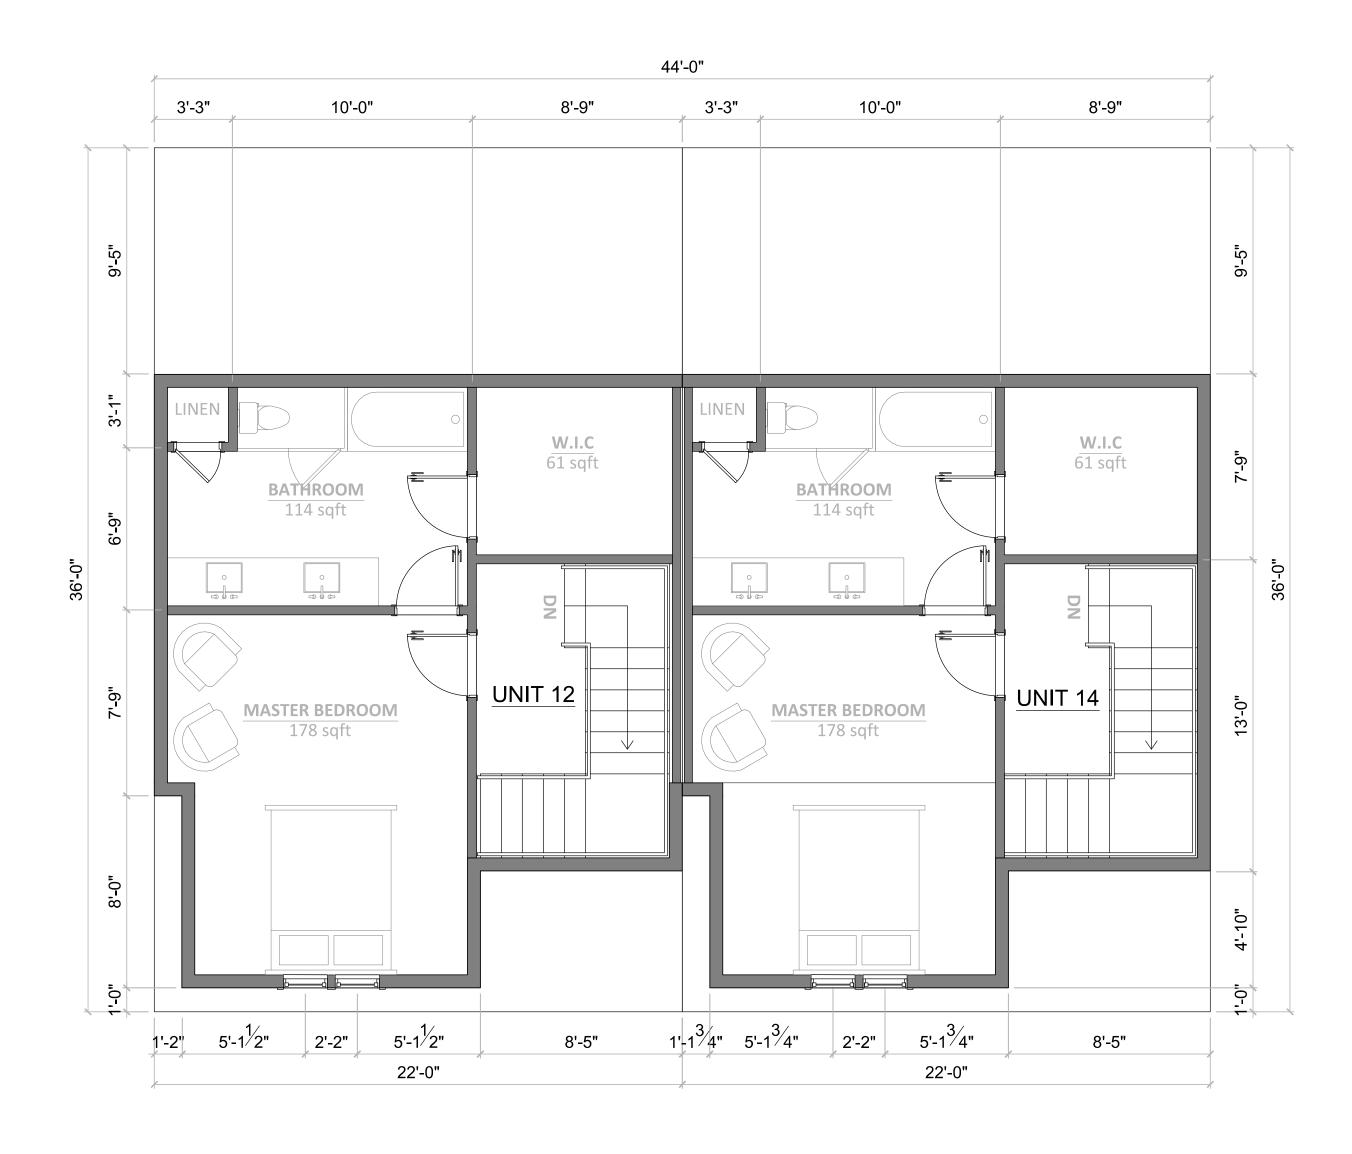

13 TYPE A - 2ND LEVEL 1/4" = 1'-0" I CARLOS FERREIRA, MASSACHUSETTS PROFESSIONAL ENGINEER, CERTIFY THAT THIS PLAN HAS BEEN PREPARED IN CONFORMITY WITH THE RULES AND REGULATIONS OF THE REGISTRAR OF DEEDS OF THE COMMONWEALTH OF MASSACHUSETTS.

I CERTIFY THAT THIS PLAN FULLY AND ACCURATELY DEPICTS THE LAYOUT, LOCATION, UNIT NUMBER AND DIMENSIONS OF BUILDING A UNITS 12 AND 14 EXCLUSIVE USE AREAS COMMON AREAS AND ARE THE DIMENSIONS OF THE UNITS AS BUILT OF THE GASPAR AT DYER 10 CONDOMINIUM LOCATED AT DYER STREET, ROCKLAND, MASSACHUSETTS.

of chas hount

OCTOBER 1, 2025

CARLOS FERREIR

PROFESSIONAL ENGINEER 41.423 MA

GASPAR AT DYER 10
Condominium
ADDRESS: DYER STREET - ROCKLAND, MA

Building 12-14 Unit Plan

Owner of Record

Gaspar at DYER 10 LLC

245 Willis Avenue

Medford, MA 02155

SCALE: 1/4" = 1'-0" OCTOBER 1, 2025

MF ENGINEERING & DESIGN

1188 CHESTNUT STREET - NEWTON , MA 02464 PHONE: (508) 331-7261